


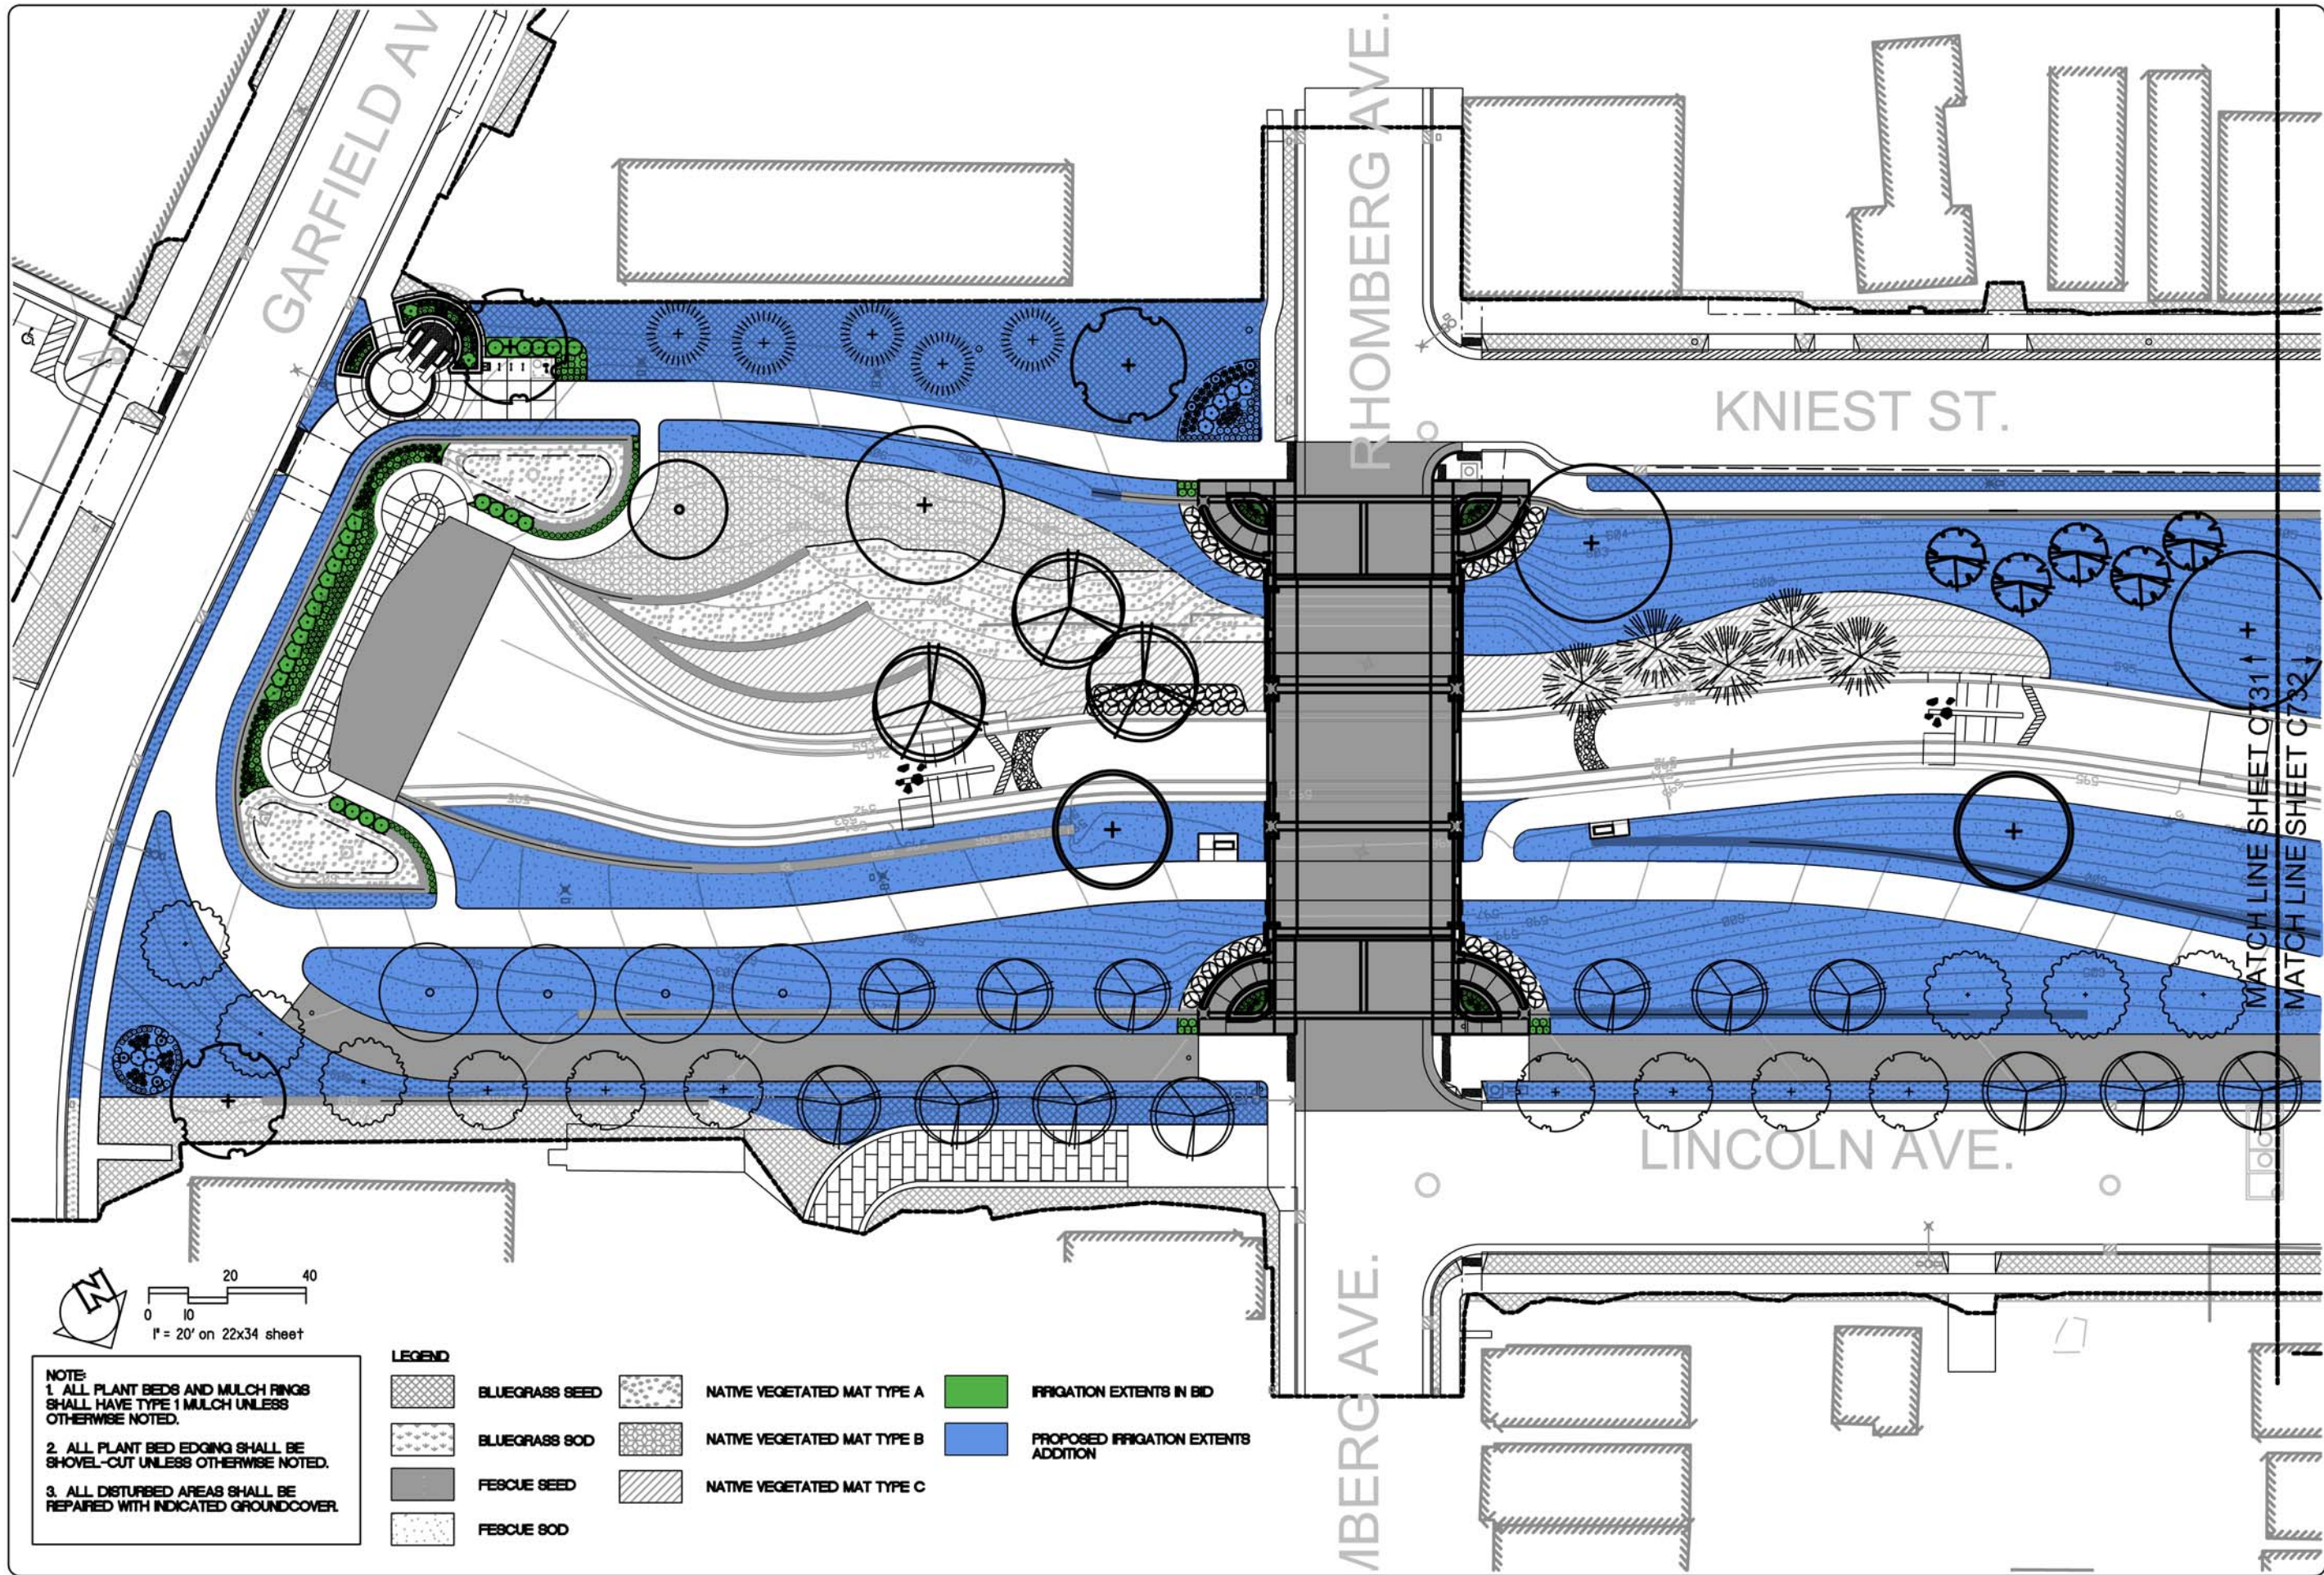

NOTE:
1. ALL PLANT BEDS AND MULCH RINGS SHALL HAVE TYPE 1 MULCH UNLESS OTHERWISE NOTED.
2. ALL PLANT BED EDGING SHALL BE SHOVEL-CUT UNLESS OTHERWISE NOTED.
3. ALL DISTURBED AREAS SHALL BE REPAIRED WITH INDICATED GROUNDCOVER.

LEGEND			
	BLUEGRASS SEED		NATIVE VEGETATED MAT TYPE A
	BLUEGRASS SOD		NATIVE VEGETATED MAT TYPE B
	FESCUE SEED		NATIVE VEGETATED MAT TYPE C
	FESCUE SOD		IRRIGATION EXTENTS IN BID
			PROPOSED IRRIGATION EXTENTS ADDITION

DATE:	REVISIONS	NO.	DATE:	DES BY: ARM	CHK BY: ARM	RECORD DRAWING	BY:	DATE:	CONTRACTOR:
4/20/16	1	1							



PLANTING PLAN
GARFIELD, LINCOLN, KNIEST
LOWER BEE BRANCH CREEK RESTORATION
CHANNELS, STREETS & UTILITIES - CONTRACT 1-2015
CITY OF DUBUQUE
DUBUQUE COUNTY, IOWA

KEN SAIKI DESIGN
LANDSCAPE ARCHITECTS
303 S. PATERSON
SUITE ONE
MADISON, WI 53703
Phone: 608 251-3600

STRAND ASSOCIATES, INC. ENGINEERS

SHEET
C731

JOB NO. 1154.007

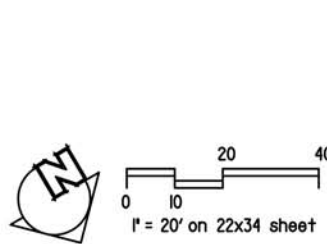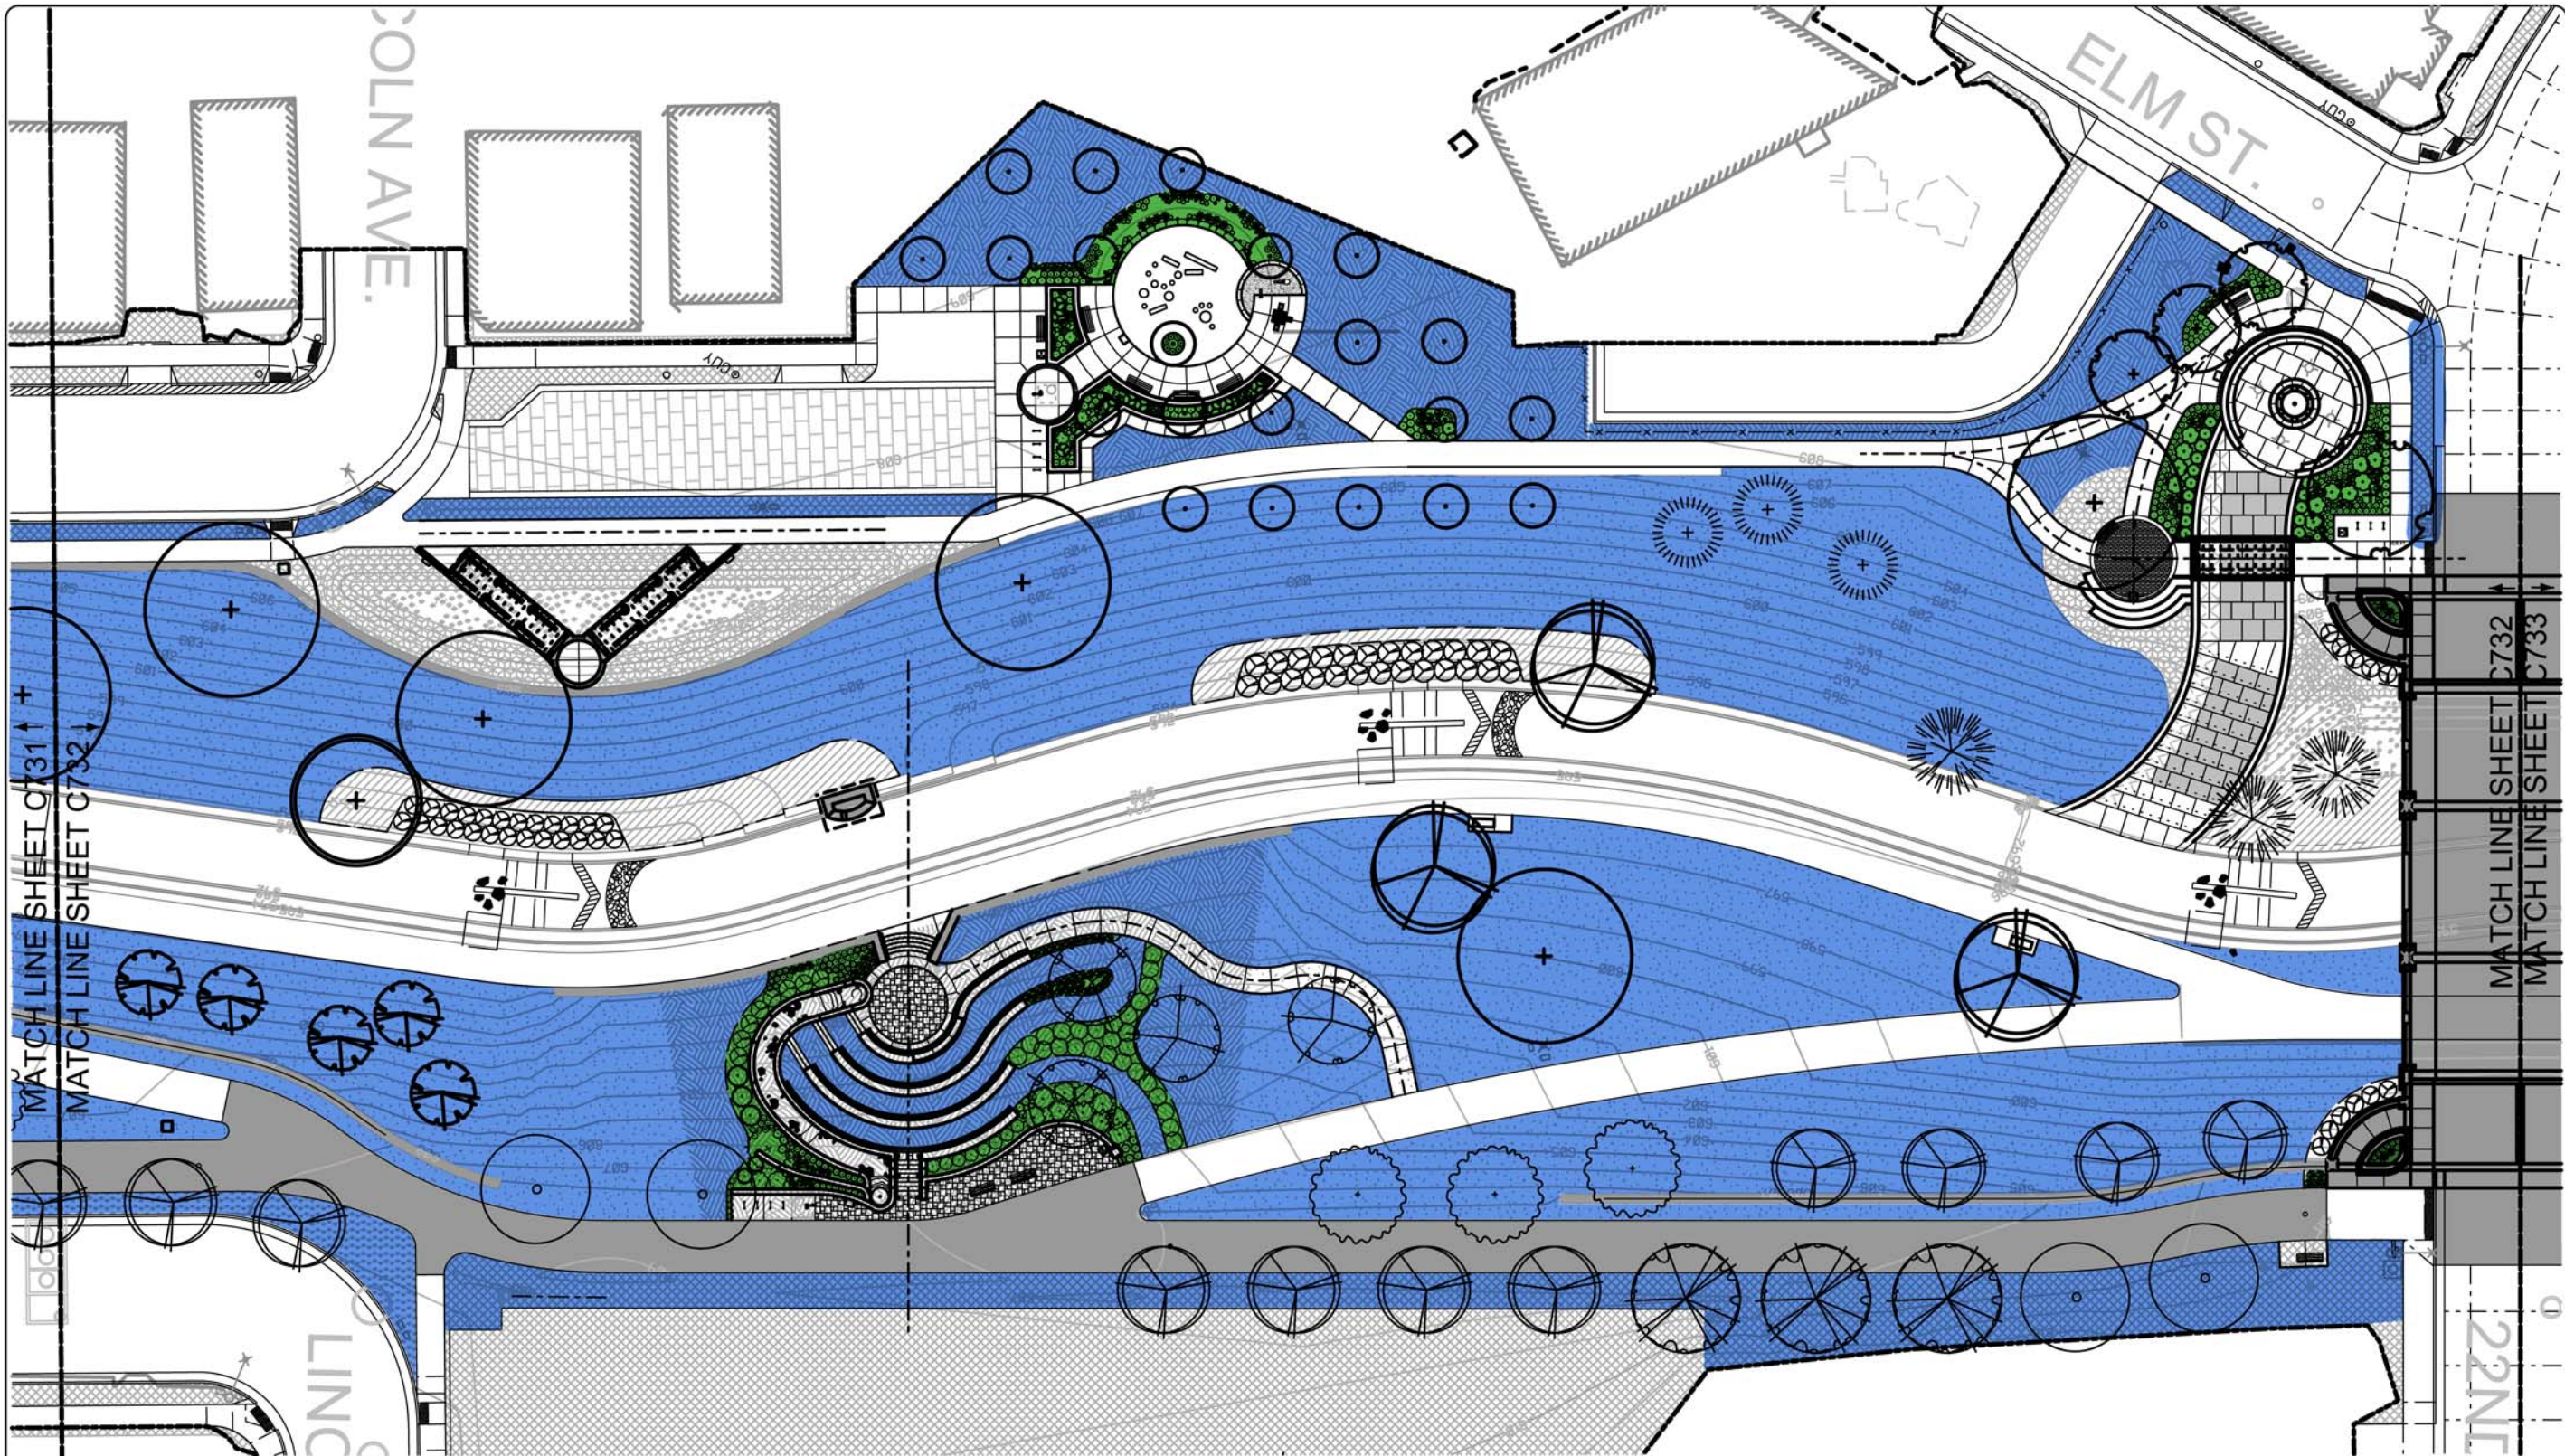

LEGEND			
	BLUEGRASS SEED		NATIVE VEGETATED MAT TYPE A
	BLUEGRASS SOD		NATIVE VEGETATED MAT TYPE B
	FESCUE SEED		NATIVE VEGETATED MAT TYPE C
	FESCUE SOD		IRRIGATION EXTENTS IN BID
			PROPOSED IRRIGATION EXTENTS ADDITION

NOTE:
1. ALL PLANT BEDS AND MULCH RINGS SHALL HAVE TYPE 1 MULCH UNLESS OTHERWISE NOTED.
2. ALL PLANT BED EDGING SHALL BE SHOVEL-CUT UNLESS OTHERWISE NOTED.
3. ALL DISTURBED AREAS SHALL BE REPAIRED WITH INDICATED GROUND COVER.

DATE: 4/20/16	
NO. 1	IRRIG. EXTENTS
DES BY: ARM CHK BY: ARM	
RECORD DRAWING	
BY:	DATE:
CONTRACTOR:	

PLANTING PLAN
LINCOLN, 22ND STREET
LOWER BEE BRANCH CREEK RESTORATION
CHANNELS, STREETS & UTILITIES - CONTRACT 1-2015
CITY OF DUBUQUE
DUBUQUE COUNTY, IOWA


KEN SAIKI DESIGN
LANDSCAPE ARCHITECTS
303 S. PATERSON
SUITE ONE
MADISON, WI 53703
Phone: 608 251-3600

STRAND ASSOCIATES, INC. ENGINEERS

SHEET
C732


JOB NO. 1154.007

NOTE:
 1. ALL PLANT BEDS AND MULCH RINGS SHALL HAVE TYPE 1 MULCH UNLESS OTHERWISE NOTED.
 2. ALL PLANT BED EDGING SHALL BE SHOVEL-CUT UNLESS OTHERWISE NOTED.
 3. ALL DISTURBED AREAS SHALL BE REPAIRED WITH INDICATED GROUND COVER.

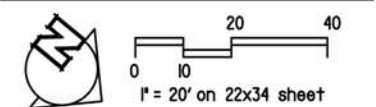

LEGEND

	BLUEGRASS SEED		NATIVE VEGETATED MAT TYPE A		IRRIGATION EXTENTS IN BID		PROPOSED IRRIGATION EXTENTS ADDITION
	BLUEGRASS SOD		NATIVE VEGETATED MAT TYPE B				
	FESCUE SEED		NATIVE VEGETATED MAT TYPE C				
	FESCUE SOD						

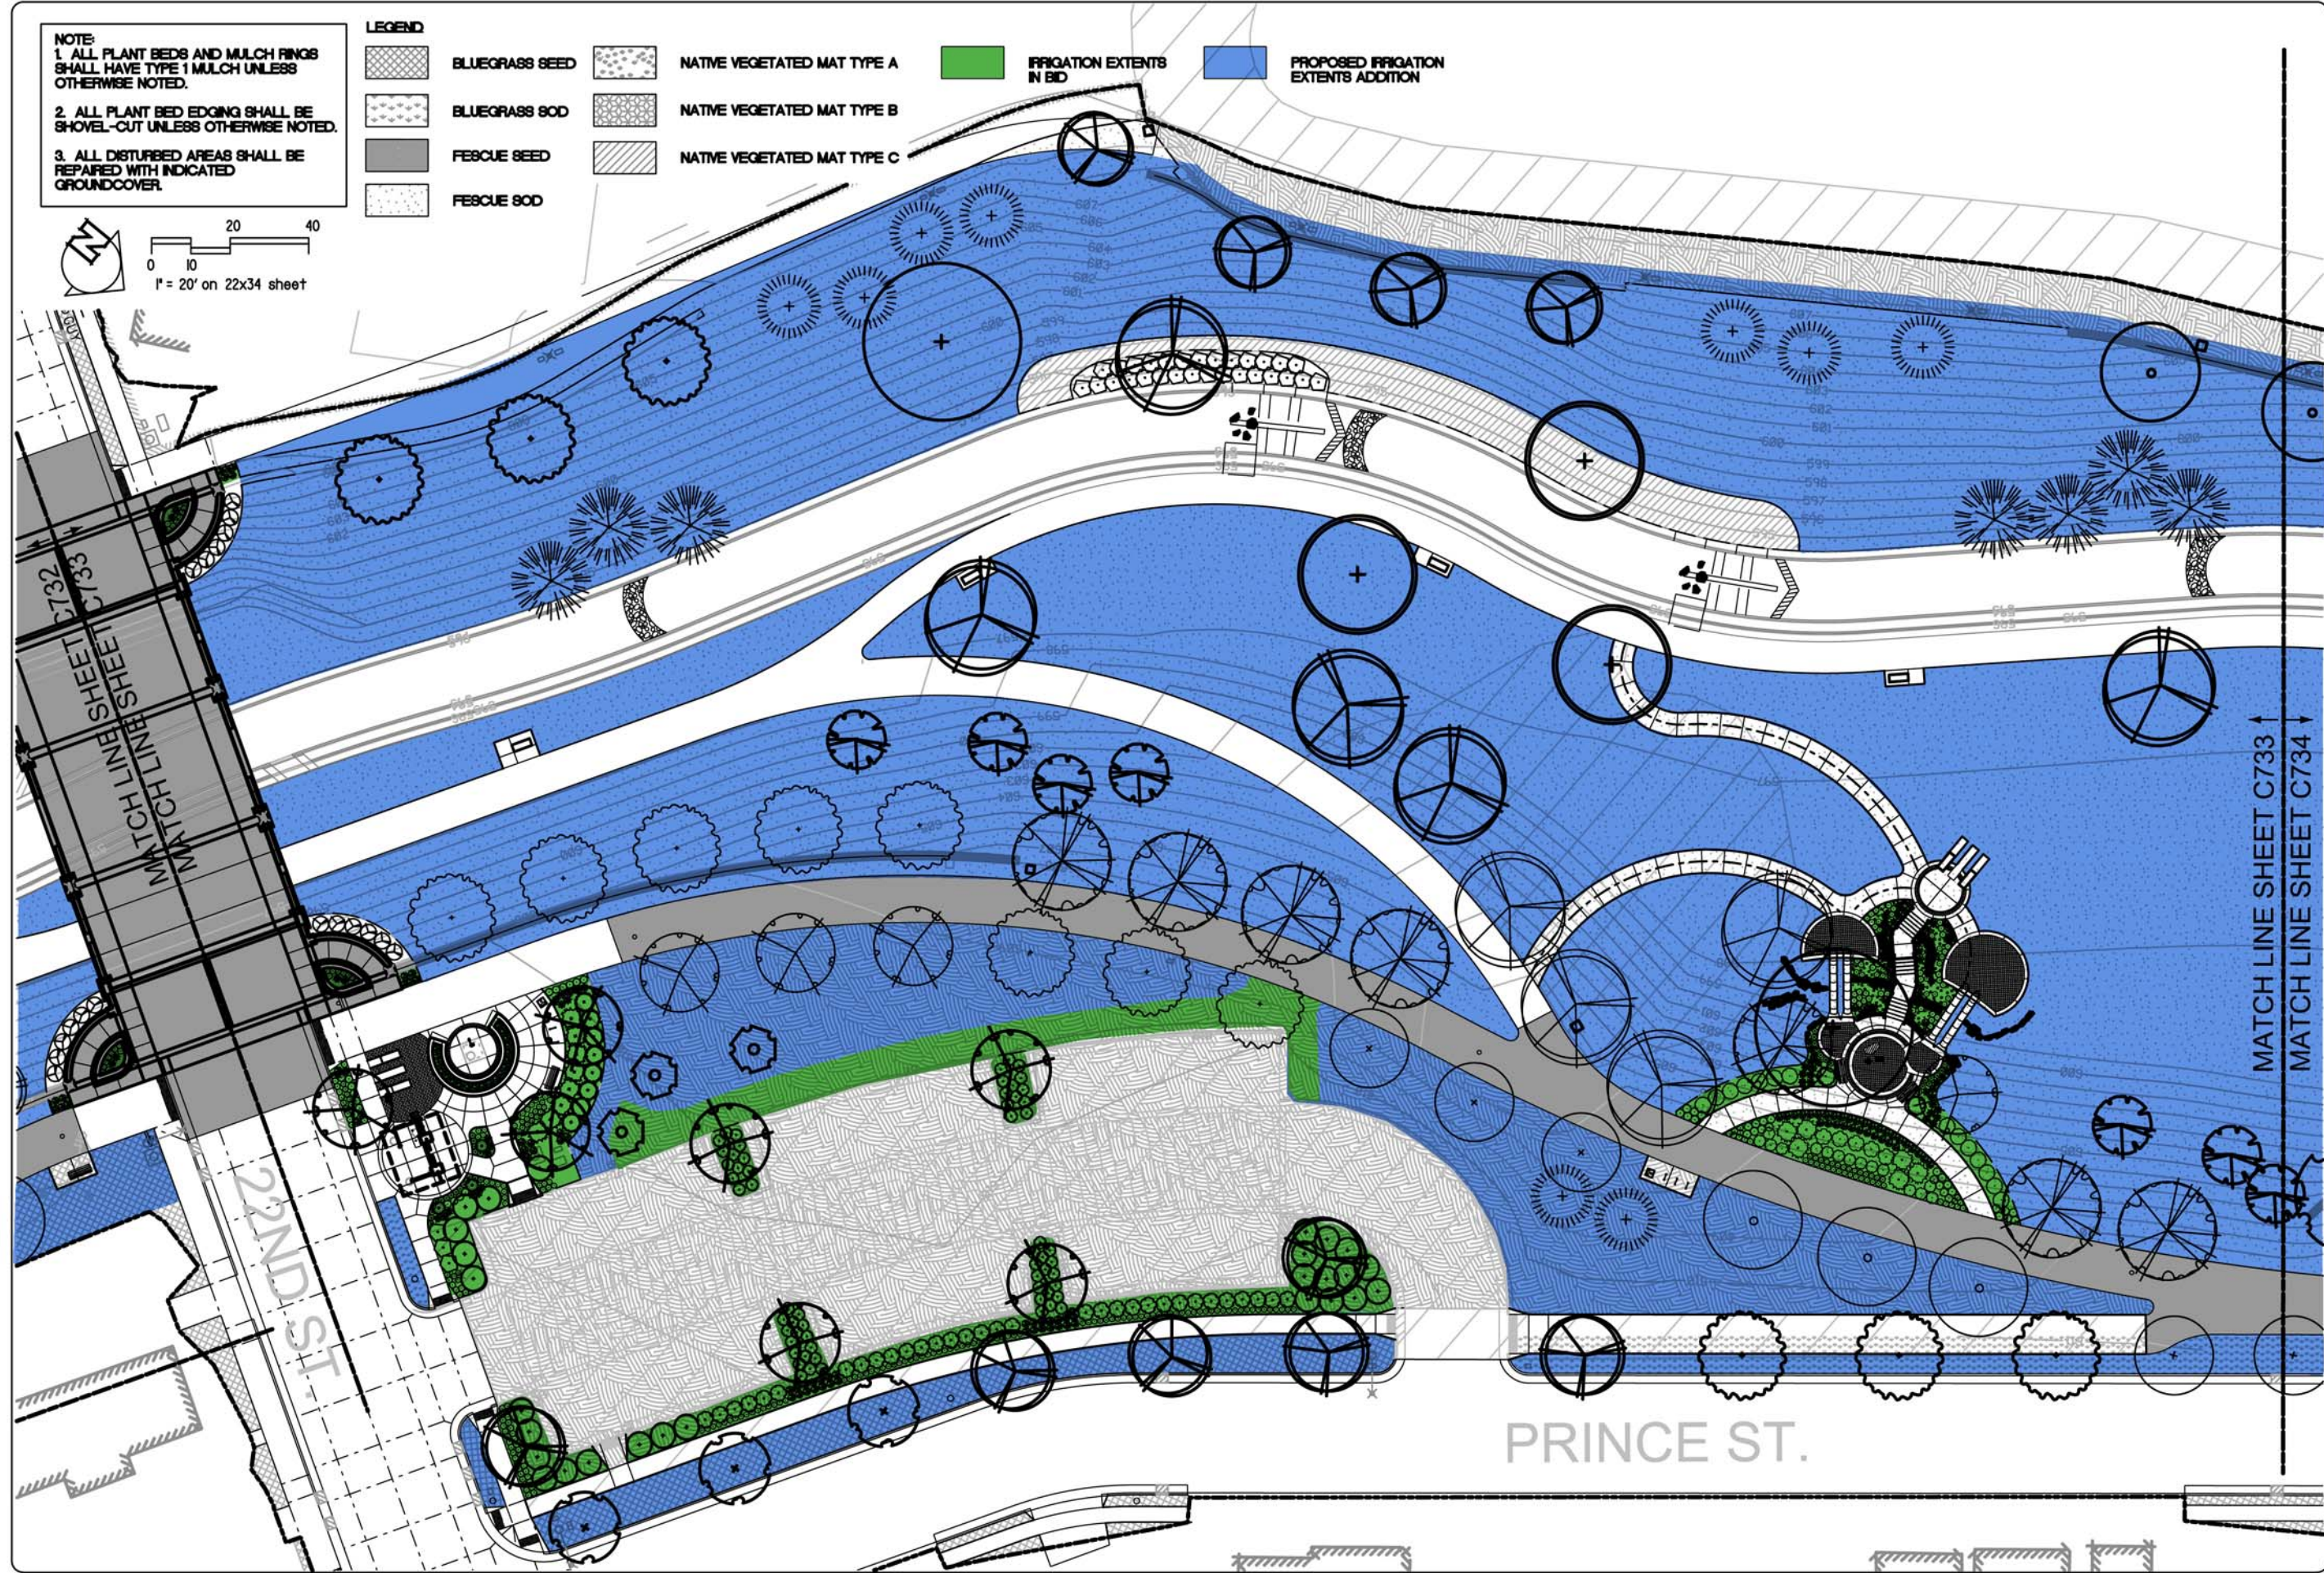

DATE:	DES BY: ARM	CHK BY: ARM	RECORD DRAWING	BY:	DATE:	CONTRACTOR:



PLANTING PLAN
22ND STREET, SLIDES
 LOWER BEE BRANCH CREEK RESTORATION
 CHANNELS, STREETS & UTILITIES - CONTRACT 1-2015
 CITY OF DUBUQUE
 DUBUQUE COUNTY, IOWA

KEN SAIKI DESIGN
 LANDSCAPE ARCHITECTS
 303 S. PATERSON
 SUITE ONE
 MADISON, WI 53703
 Phone: 608 251-3600

STRAND ASSOCIATES, INC.
 ENGINEERS

NOTE:
1. ALL PLANT BEDS AND MULCH RINGS SHALL HAVE TYPE 1 MULCH UNLESS OTHERWISE NOTED.
2. ALL PLANT BED EDGING SHALL BE SHOVEL-CUT UNLESS OTHERWISE NOTED.
3. ALL DISTURBED AREAS SHALL BE REPAIRED WITH INDICATED GROUND COVER.

- LEGEND
- | | | | |
|--|----------------|--|--------------------------------------|
| | BLUEGRASS SEED | | NATIVE VEGETATED MAT TYPE A |
| | BLUEGRASS SOD | | NATIVE VEGETATED MAT TYPE B |
| | FESCUE SEED | | NATIVE VEGETATED MAT TYPE C |
| | FESCUE SOD | | IRRIGATION EXTENTS IN BID |
| | | | PROPOSED IRRIGATION EXTENTS ADDITION |

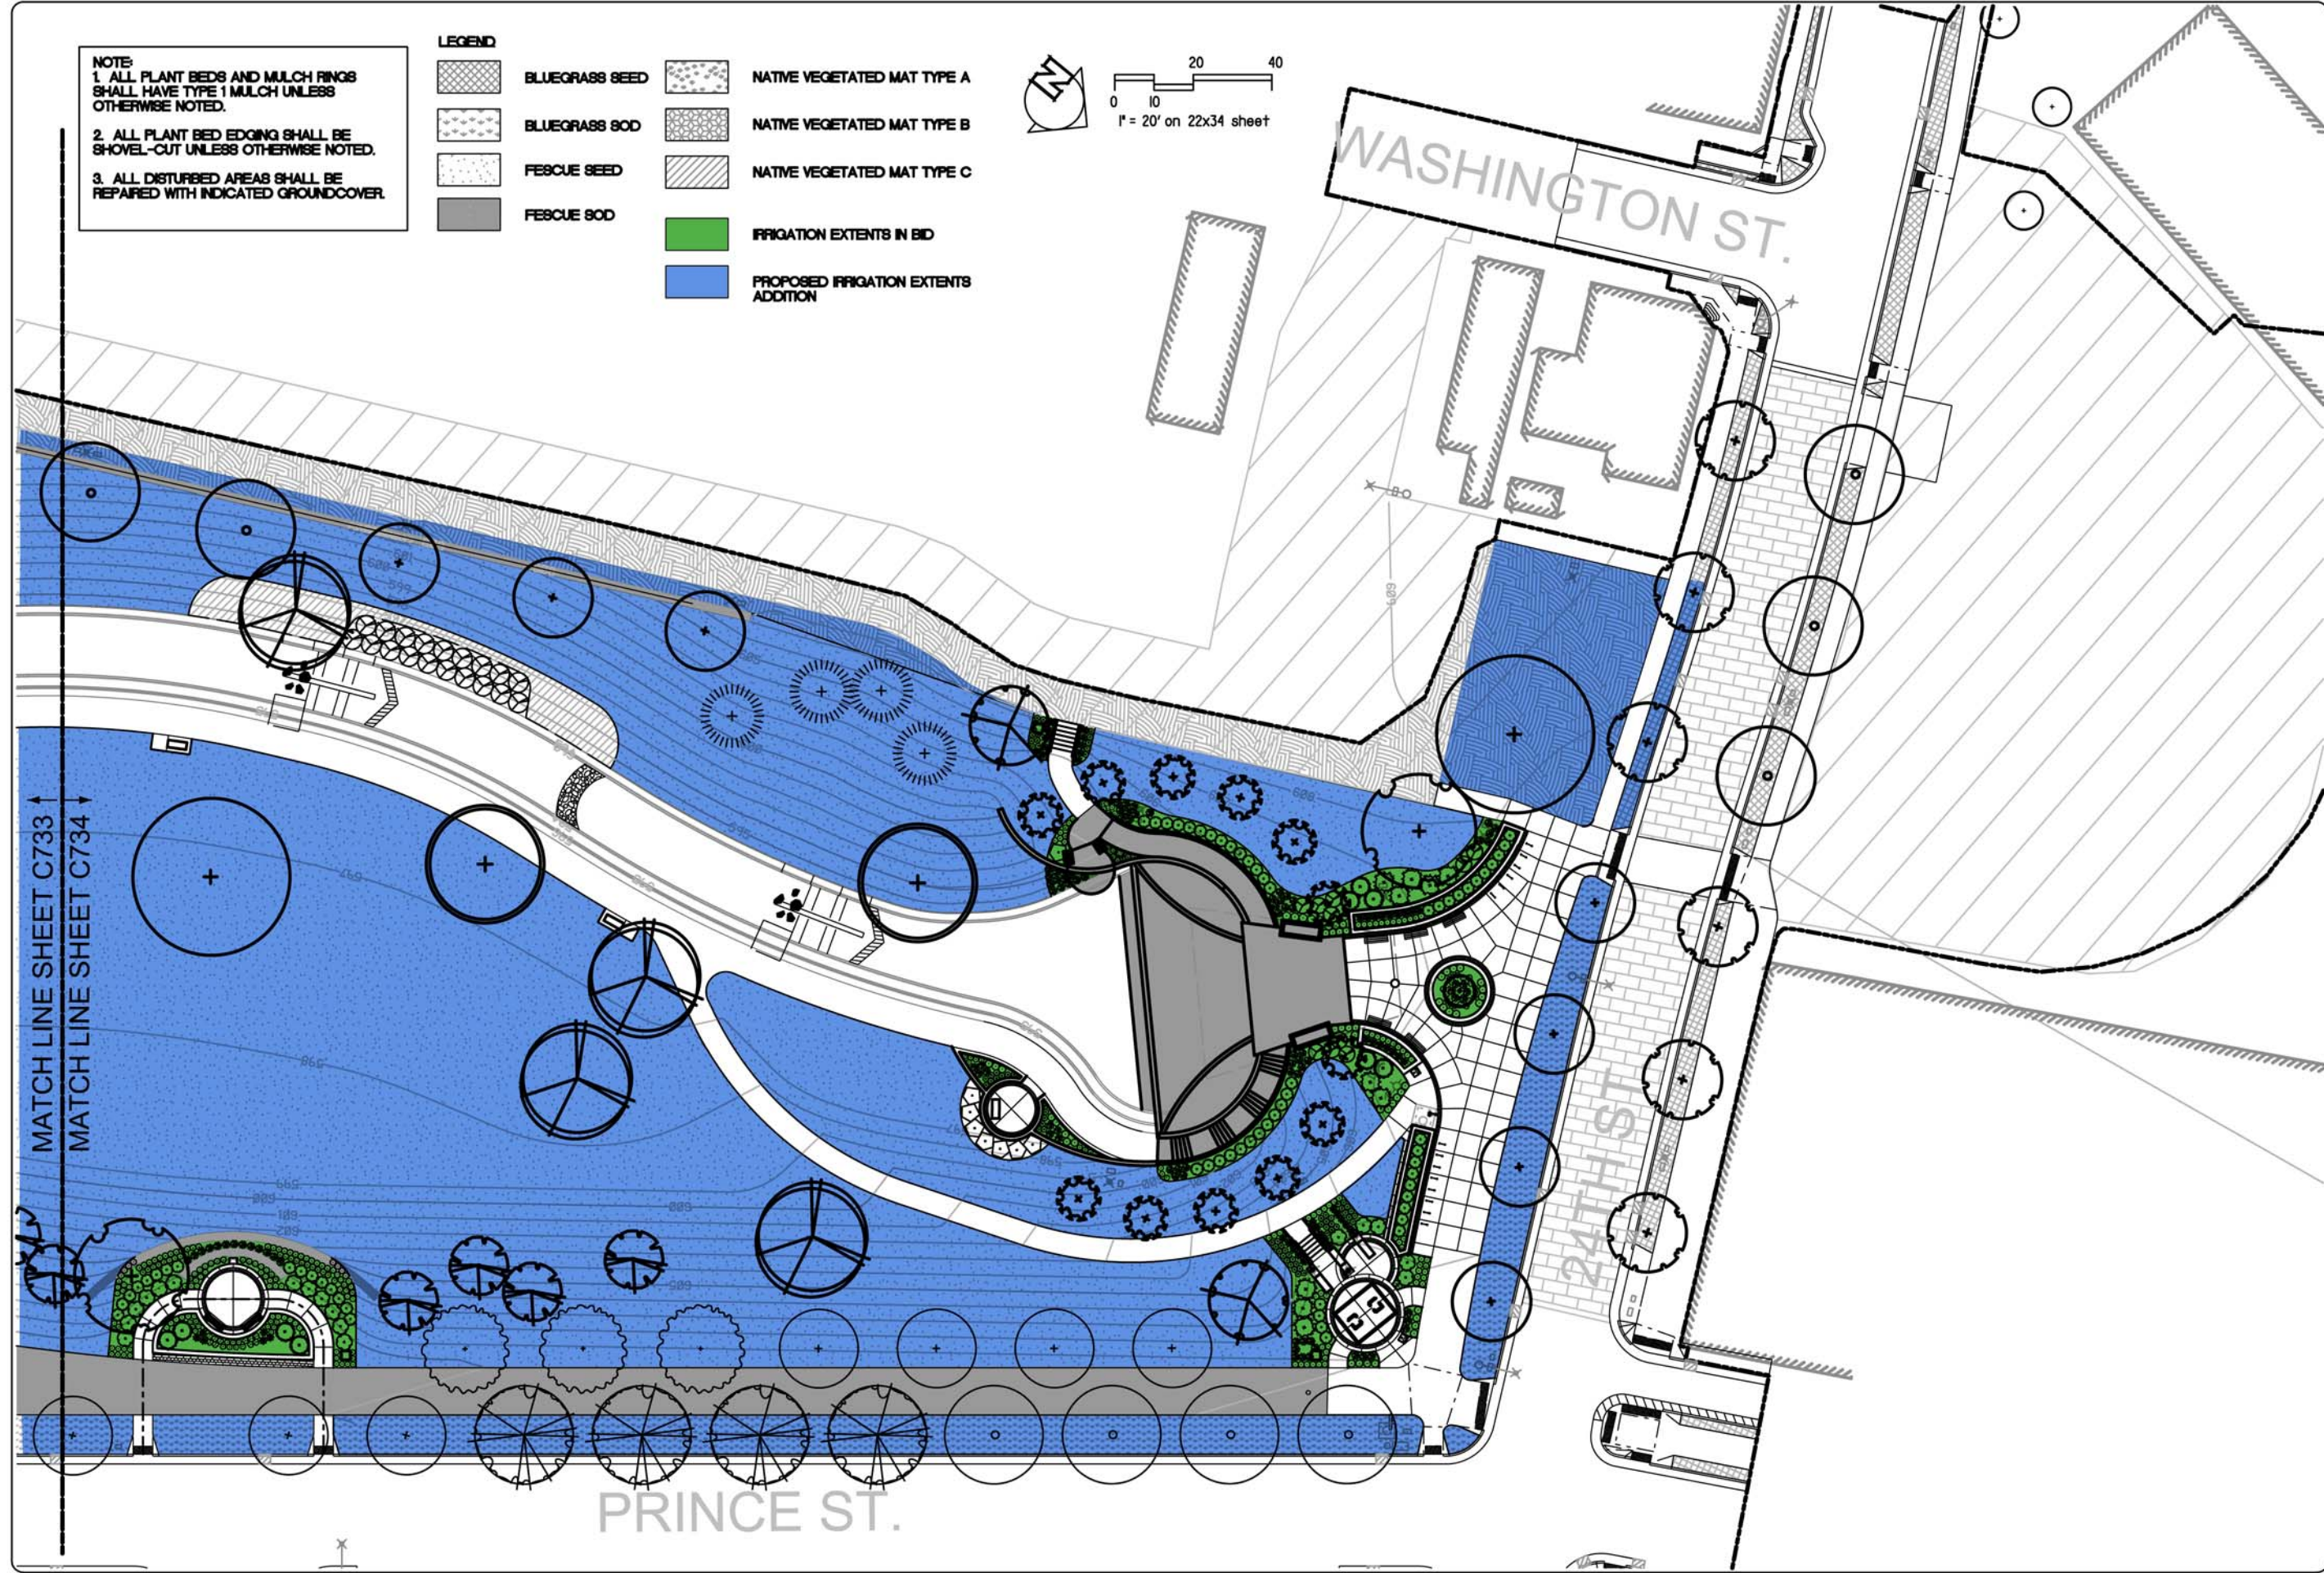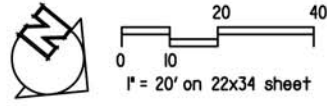

DATE: 9/9/15	
REVISIONS	WCD #7
NO. 1	
DES BY: ARM	CHK BY: ARM
RECORD DRAWING	
BY:	DATE:
CONTRACTOR:	

PLANTING PLAN
PRINCE ST. OVERLOOK, COMISKEY PARK
LOWER BEE BRANCH CREEK RESTORATION
CHANNELS, STREETS & UTILITIES - CONTRACT 1-2015
CITY OF DUBUQUE
DUBUQUE COUNTY, IOWA

KEN SAIKI DESIGN
LANDSCAPE ARCHITECTS
303 S. PATERSON
SUITE ONE
MADISON, WI 53703
Phone: 608 251-3600

STRAND ASSOCIATES, INC.
ENGINEERS

SHEET
C734

JOB NO. 1154.007